





Scale Horiz. 1"=20'  
Vert. 1"=5'

**BENCH MARK** Elev. 766.04 F.B. 505/66  
P.K. in center of S.W. curb return Melody Lane & Garfield

- GENERAL NOTES**
- Construction shall be in accordance with the City of Riverside, Department of Public Works, Standard Specifications No. 461 and Standard Drawings.
  - It shall be the responsibility of the contractor to clear the right of way in accordance with the provisions of the laws it affects, each utility including irrigation lines and appurtenances and at no cost to the City.
  - Joints in vitrified clay pipe sewer shall conform to ASTM Standard C-425-60T, or the latest revision thereof.
  - Pipe shall be bedded per Case II, Standard Drawing No. 452, unless otherwise specified on plan.
  - NOTICE TO CONTRACTOR:** The existence and location of any underground utility pipes or structures shown on these plans are obtained by a search of the available records. To the best of our knowledge, there are no existing utilities, except as shown on these plans. The contractor is required to take due precautionary measures to protect the utility lines shown and any other lines not of record or not shown on these plans.

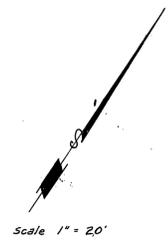

Scale 1" = 20'

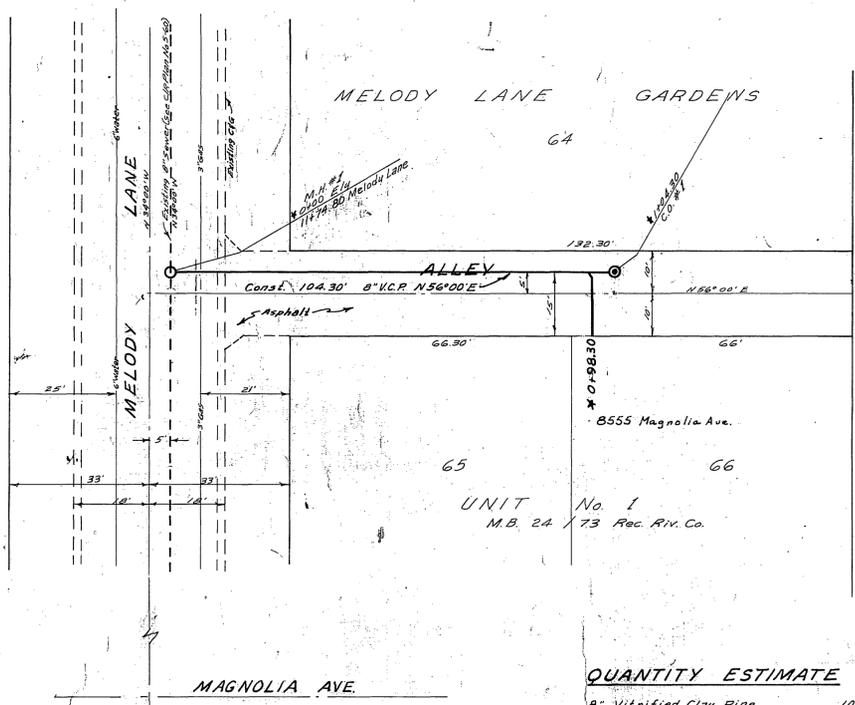

UNIT No. 1  
M.B. 24 / 73 Rec. Riv. Co.

**QUANTITY ESTIMATE**

8" Vitrified Clay Pipe	104	L.F.
4" Vitrified Clay Pipe	15	L.F.
4" X 8" Wye	1	EA.
Manhole Standard No. 500	1	EA.
Clean out Standard No. 560	1	EA.
Pavement replacement	287	S.F.

\* As built 10/15/64 B.E.

**ALBERT A. WEBB ASSOCIATES**  
CIVIL ENGINEERS  
RIVERSIDE CALIFORNIA

REVISIONS		
MARK	DATE	DESCRIPTION

CITY OF RIVERSIDE CALIFORNIA  
DEPARTMENT OF PUBLIC WORKS

**SEWER PLAN & PROFILE**

**ALLEY**

**E/W OF MELODY LANE**

**N/W of Magnolia Ave.**

DESIGNED BY DRAWN BY B.E.L.	CHECKED BY W.O. 64-218	APPROVED BY DIRECTOR OF PUBLIC WORKS	S-556
RECOMMENDED BY C. J. W. D. O.	DATE 7-23-64	SHEET 1 OF 1	

DWG. No. 64-218-A

PROFILE	SUBMITTED	BY	DATE
NOTE BOOK	PLOTTED		
GRADES CHECKED			
NO. 3			

PLAN	SUBMITTED	BY	DATE
NOTE BOOK	PLOTTED		